


**WARNING**  
BEWARE OF UNDERGROUND/OVERHEAD SERVICES  
THE LOCATION OF SERVICES ARE APPROXIMATE ONLY AND THEIR EXACT POSITION SHOULD BE PROVEN ON SITE. NO GUARANTEE IS GIVEN THAT ALL EXISTING SERVICES ARE SHOWN. SPECIAL CONSIDERATION SHOULD BE GIVEN TO CONSTRUCTION PROCEDURES UNDER OVERHEAD ELECTRICITY TRANSMISSION LINES.

file name: 308910CR200.dwg, User: m.ganji, Date: 08/10/2024, 12:13 PM, Sheet: 2 of 15, Sheets

Rev	Amendments	Approved	Date
8	RET WALL ADDED LOT 111	N.G	08/10/2024
6	AS CONSTRUCTED	N.G	10/11/23
5	AS CONSTRUCTED	N.G	19/10/23
4	UPDATED DRAINAGE LS, PIT SCHEDULE AND SWD PIPE SIZE ON PUNNET STREET	N.G	20/04/23
3	S & D OFFSET, PIT SCHEDULE COORDINATES UPDATED	N.G	06/03/23
2	ISSUED TO COUNCIL FOR APPROVAL	N.G	01/03/23
1	ISSUED TO COUNCIL FOR APPROVAL	N.G	28/02/23
0	ISSUED FOR CONSTRUCTION	N.G	16/02/23

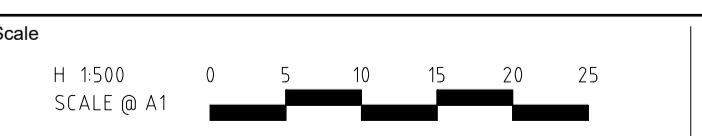

System Certified  
 © Spiire Australia Pty Ltd All Rights Reserved  
 This document is produced by Spiire Australia Pty Ltd solely for the benefit of and use by the client in accordance with the terms of the retainer. Spiire Australia Pty Ltd does not and shall not assume any responsibility or liability whatsoever to any third party arising out of any use or reliance by third party on the content of this document.

L6 414 LA TROBE STREET PO BOX 16084 MELBOURNE  
 VICTORIA 8007 AUSTRALIA T 61 3 9993 7888  
 spiire.com.au ABN 55 050 029 635

Designed <b>M.GANJI</b>	Checked <b>N. WORME</b>
Authorised <b>N. GREEN</b>	Date <b>08/10/2024</b>

**250 WEDGE ROAD**  
**STAGE 1**  
**ROAD AND DRAINAGE**  
**FACE PLAN- SHEET 1 OF 2**  
 CITY OF FRANKSTON  
 WEDGE ROAD DEVELOPMENT PTY LTD (YOURLAND)

**AS CONSTRUCTED**

 Drg No  
**308910CR200**

 Rev  
**8**